

NOTICE TO MARINERS

DOGGER BANK OFFSHORE WIND FARM

DATE OF ISSUE:	08/05/2024
NOTICE TO MARINER NUMBER	LF700013-MIP-DOG-NOT-0011 Rev 02

Dogger Bank C Boundary Buoy Installation

LOCATION DESCRIPTION		Dogger Bank C Offshore Windfarm Construction Area
COORDINATES WGS 84	DBC OWF Location	See Table 1 below
Date of Installation		08/05/2025

Description of Installation

The Trinity House Buoy Installation Vessel, **Galatea**, has installed the Dogger Bank C boundary demarcation buoys in the Southern North Sea.

The 17 construction boundary demarcation buoys will remain in location until the windfarm construction activities have been completed and handed over to the Operations and Maintenance teams.

Once the permanent Aids to Navigation (AtoN) have been installed on the WTGs, Trinity House will approve the permanent AtoN and the boundary buoys will be removed.

If anyone finds a buoy that is off station or encounters a buoy location where it is not functioning or is missing, they should report this to the Dogger Bank Duty Marine Coordinator as soon as possible.

Contact Details

Marine Coordination Contact	Duty Marine Coordinator Tel: +44 (0) 7586 332078 gm_dbmcc@equinor.com
Fisheries Liaison Officer (FLO) CONTACT	Alex Winrow-Giffin, Brown & May Marine Ltd Alex@brownmay.com Tel: 01379 870181 Mob: 07760 160039 Zoë Lawrence - Brown & May Marine Ltd zoe@brownmay.com Mob: 07923 138175

NOTICE TO MARINERS

DOGGER BANK WIND FARM

Supporting Information

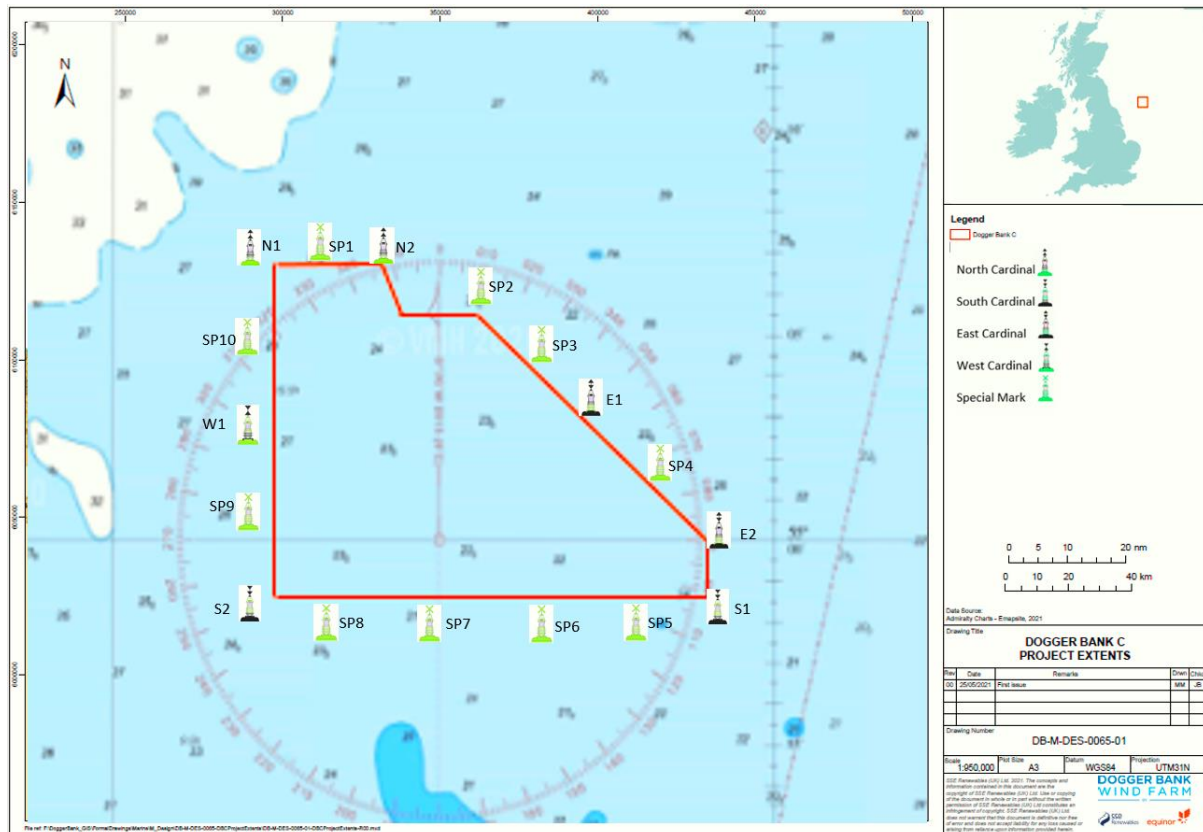


Figure 1: DBC Boundary Buoyage locations

Table 1: DBC Planned locations for construction boundary buoys

Buoy	ID	Location Datum: WGS 84		Top Mark and Light Specifications
		Latitude	Longitude	
North Cardinal	N1	55° 07.418' N	002° 34.283' E	<ul style="list-style-type: none"> Pillar shaped with a north cardinal shaped topmark Exhibiting a Q light character
North Cardinal	N2	55° 07.438' N	002° 42.677' E	<ul style="list-style-type: none"> Pillar shaped with a north cardinal shaped topmark Exhibiting a Very (V) Quick (Q) light character
East Cardinal	E1	55° 02.953' N	002° 51.690' E	<ul style="list-style-type: none"> Pillar shaped with an east shaped topmark Exhibiting a Q (3) 10s light character
East Cardinal	E2	54° 58.621' N	002° 57.446' E	<ul style="list-style-type: none"> Pillar shaped with an east cardinal shaped topmark Exhibiting a V Q (3) 5s light character
South Cardinal	S1	54° 57.020' N	002° 57.366' E	<ul style="list-style-type: none"> Pillar shaped with a south cardinal shaped topmark Exhibiting a V Q (6) + L Fl 10s light character
South Cardinal	S2	54° 57.251' N	002° 34.311' E	<ul style="list-style-type: none"> Pillar shaped with a south cardinal shaped topmark Exhibiting a Q (6) Long (L) Fl 15s light character
West Cardinal	W1	55° 02.331' N	002° 33.863' E	<ul style="list-style-type: none"> Pillar shaped with a west cardinal shaped topmark Exhibiting a Q (9) 15s light character
Special Mark	SP1	55° 07.426' N	002° 38.478' E	<ul style="list-style-type: none"> Pillar shaped with a yellow 'x' shaped topmark Exhibiting a Fl. Y. 5 s light character
Special Mark	SP2	55° 05.943' N	002° 45.683' E	<ul style="list-style-type: none"> Pillar shaped with a yellow 'x' shaped topmark Exhibiting a Fl. Y. 5 s light character
Special Mark	SP3	55° 04.448' N	002° 48.688' E	<ul style="list-style-type: none"> Pillar shaped with a yellow 'x' shaped topmark Exhibiting a Fl. Y. 5 s light character

NOTICE TO MARINERS

Buoy	ID	Location Datum: WGS 84		Top Mark and Light Specifications
		Latitude	Longitude	
Special Mark	SP4	55° 00.787'N	002° 54.570'E	<ul style="list-style-type: none"> • Pillar shaped with a yellow 'x' shaped topmark • Exhibiting a Fl. Y. 5 s light character
Special Mark	SP5	54° 57.066'N	002° 52.755'E	<ul style="list-style-type: none"> • Pillar shaped with a yellow 'x' shaped topmark • Exhibiting a Fl. Y. 5 s light character
Special Mark	SP6	54° 57.112'N	002° 48.144'E	<ul style="list-style-type: none"> • Pillar shaped with a yellow 'x' shaped topmark • Exhibiting a Fl. Y. 5 s light character
Special Mark	SP7	54° 57.158'N	002° 43.533'E	<ul style="list-style-type: none"> • Pillar shaped with a yellow 'x' shaped topmark • Exhibiting a Fl. Y. 5 s light character
Special Mark	SP8	54° 57.204'N	002° 38.922'E	<ul style="list-style-type: none"> • Pillar shaped with a yellow 'x' shaped topmark • Exhibiting a Fl. Y. 5 s light character
Special Mark	SP9	54° 59.791'N	002° 34.087'E	<ul style="list-style-type: none"> • Pillar shaped with a yellow 'x' shaped topmark • Exhibiting a Fl. Y. 5 s light character
Special Mark	SP10	55° 04.878'N	002° 34.074'E	<ul style="list-style-type: none"> • Pillar shaped with a yellow 'x' shaped topmark • Exhibiting a Fl. Y. 5 s light character

Figure 2: Boundary Buoy Characteristics

North Cardinal Mark	South Cardinal Mark	East Cardinal Mark	West Cardinal Mark	Special Mark
